


LEGEND

	WALL ABOVE FRAMING PLAN
	WALL BELOW FRAMING PLAN
	EXTERIOR WALLS: 2x6 STUDS
	INTERIOR WALLS: 2x4 STUDS
	INTERIOR LOAD BEARING WALLS:
	8" CONCRETE STEM WALL
	FLOOR SHEATHING: 3/4" APA RATED
	(NO BLKG REQ'D), SEE 2/S3.0.
	ROOF SHEATHING: 1/2" APA RATED
	(NO BLKG REQ'D), SEE 2/S3.0.
	"# " DENOTES SHEAR WALL TYPE & EDGE NAIL SPACING AND "S/W" DENOTES MINIMUM SHEAR WALL LENGTH. SEE SHEET 5/S2.0 FOR SHEAR WALL SCHEDULE. SEE DETAIL 3/S3.0 FOR SHEAR WALL FRAMING AND TYP. PENETRATIONS IN SHEAR WALL
	"###" DENOTES SHEAR WALL HOLDOWN TYPE. SEE TYPICAL DETAIL 4/S2.0 FOR INFO AND MIN. END POST SIZE
	SEE DETAIL 4/S2.0 FOR SHEAR WALL POST SIZE
	DENOTES SIMPSON HANGER PER SCHEDULE 4/S3.0, U.O.N.
	DENOTES SIMPSON CONCEALED FLANGE HANGER PER SCHEDULE 4/S3.0, U.O.N.
	SEE HEADER SCHEDULE ON 8/S3.0 FOR HEADER SIZES, UNLESS NOTED ON PLAN.
	24" WIDE x 12" CONCRETE FOOTING, U.O.N.

NOTE:

- STUD PACK FRAMING:
(4) 2X STUD PACK UNDER EACH END OF SOLID SAWN BEAM.
(6) 2X STUD PACK UNDER EACH END OF GLULAM BEAM.
(SEE PLAN FOR BEAM SIZE)

MANUFACTURE: ENGINEER DESIGN.

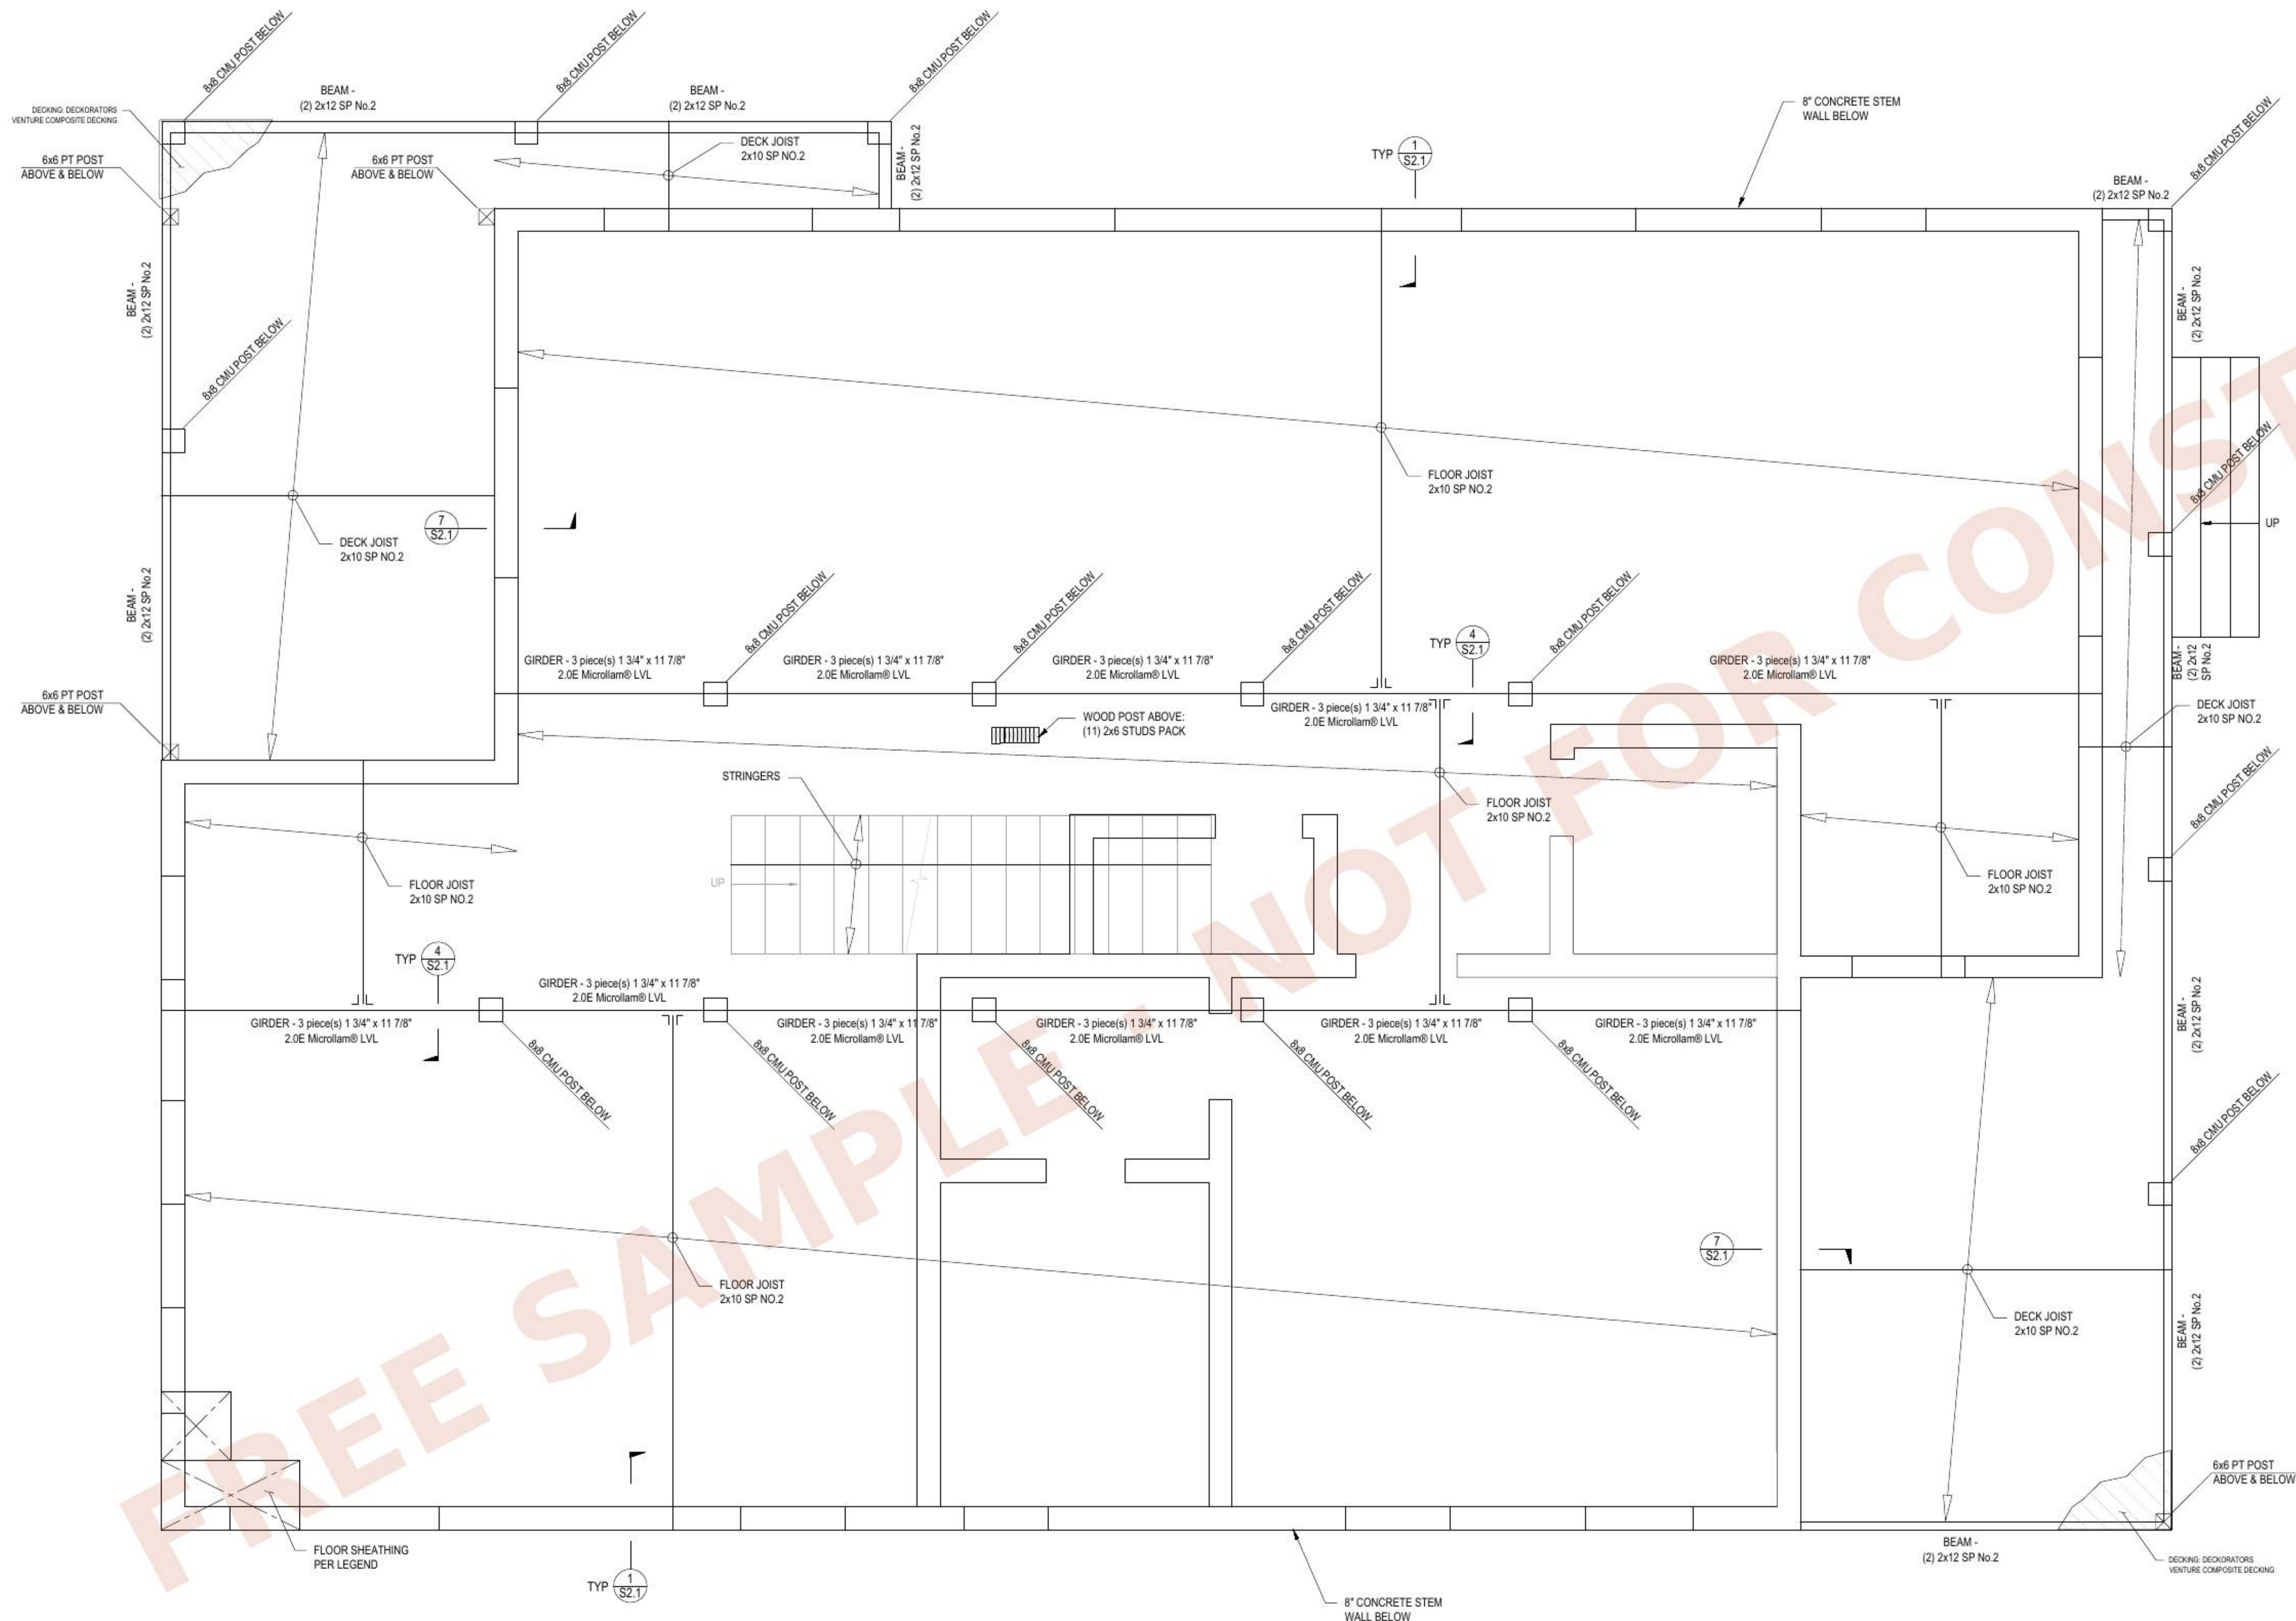

1 1ST FLOOR FRAMING PLAN

SCALE: 3/8"=1'-0"

HOUSE ARCHITECTURE USA

FREE SAMPLE - AS-BUILT
housearchitectureusa.com

PROJECT #: 3078

DRAWN BY: HL

CHECKED BY: EL


Revision Schedule		
Number	Description	Date

SHEET NAME


1ST FLOOR
FRAMING PLAN

SHEET NUMBER


S1.1

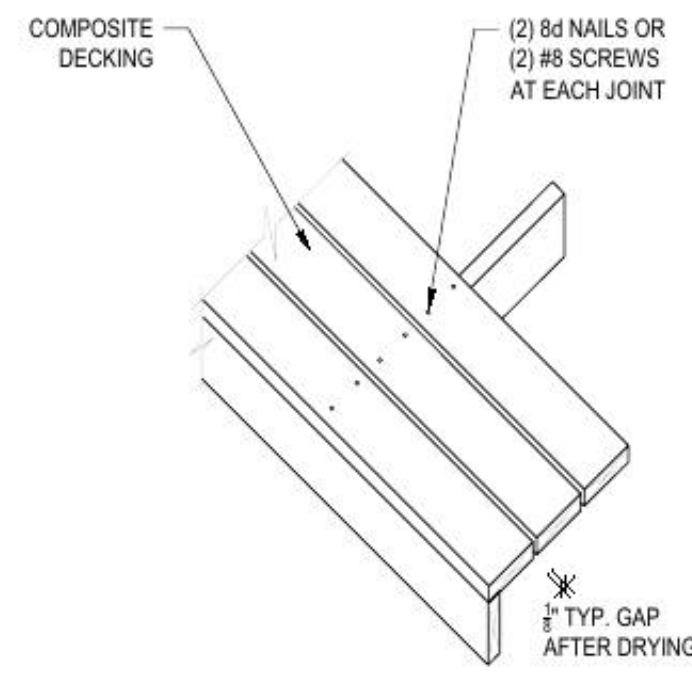


9 TYPICAL WOOD DECKING
SCALE: N.T.S.

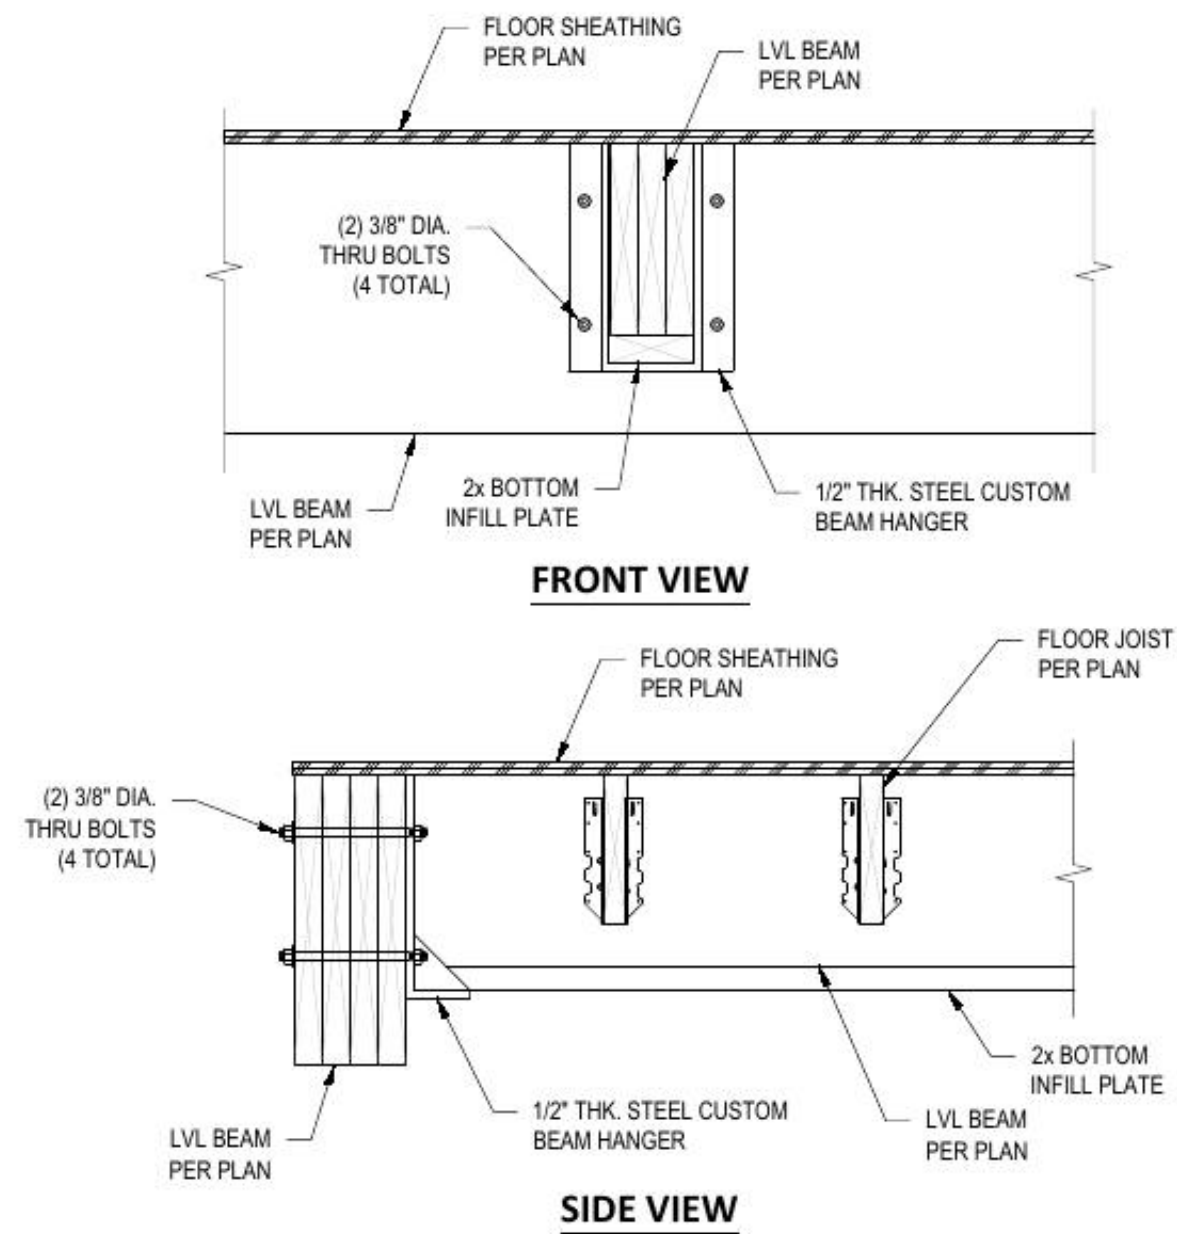


10 LVL BEAM TO BEAM CONNECTION DETAIL
SCALE: 1"=1'-0"

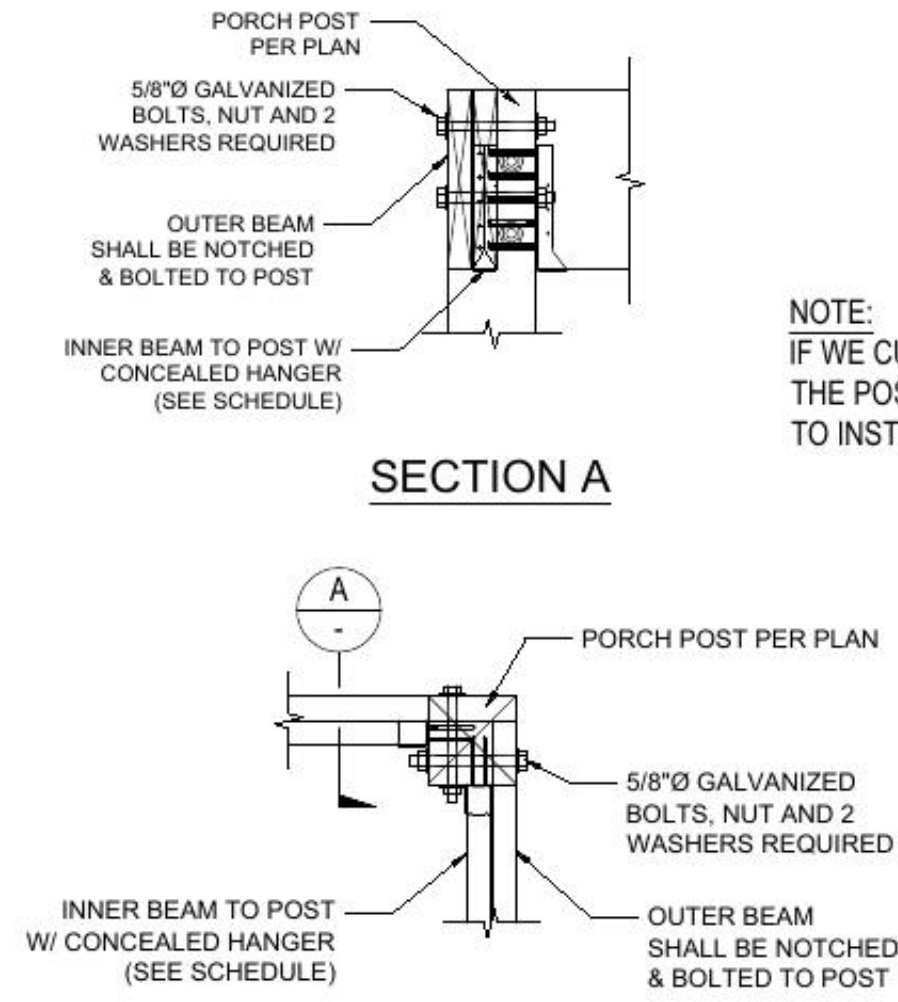


6 CORNER PORCH POST DETAIL
SCALE: 1"=1'-0"

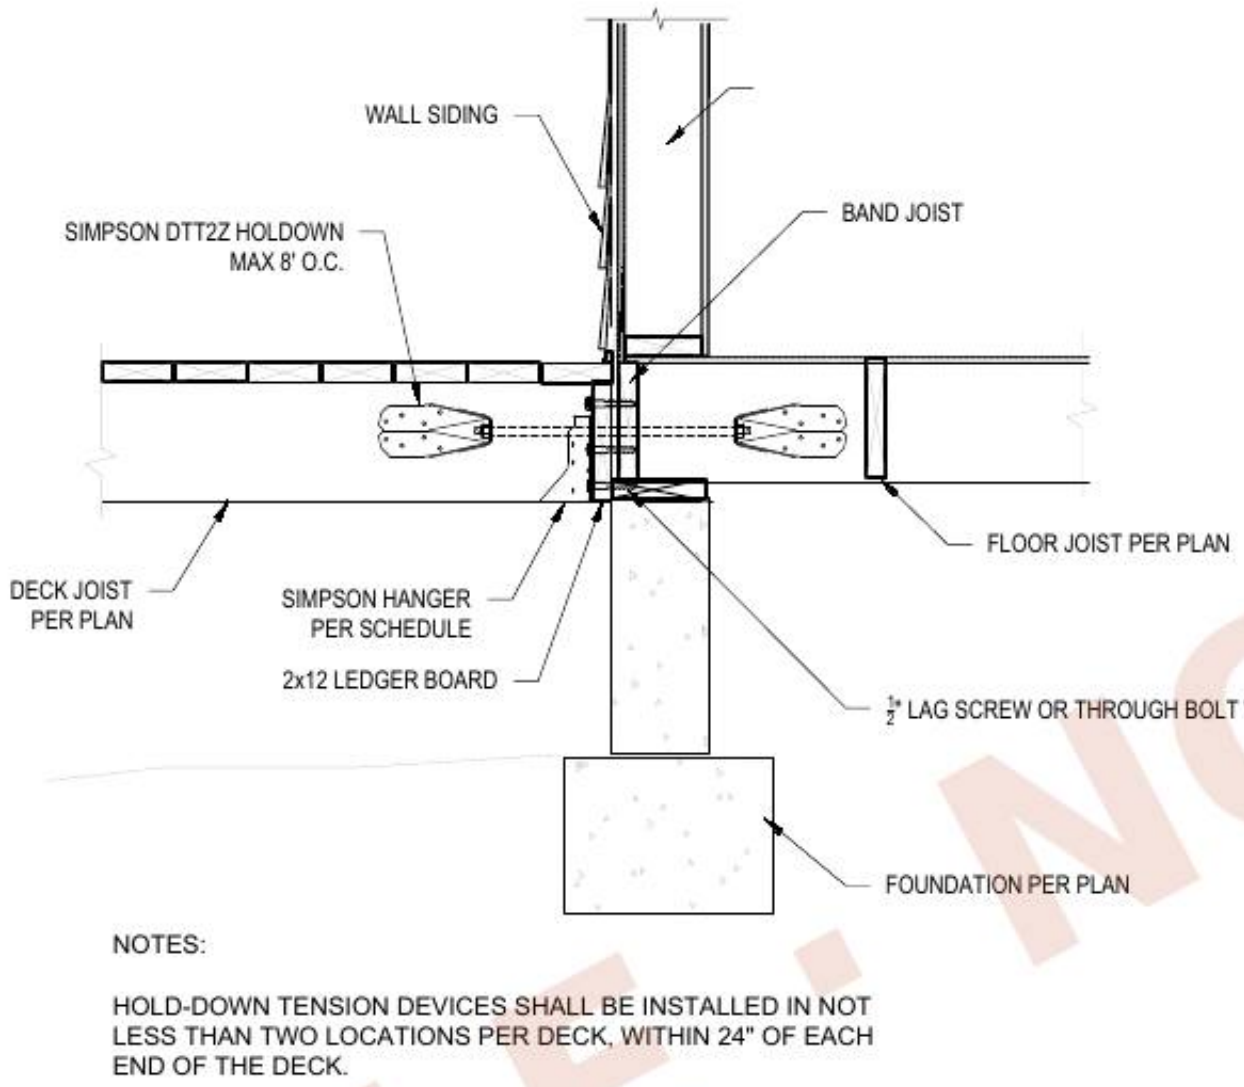


7 DECK ATTACHMENT FOR LATERAL LOADS
SCALE: N.T.S.

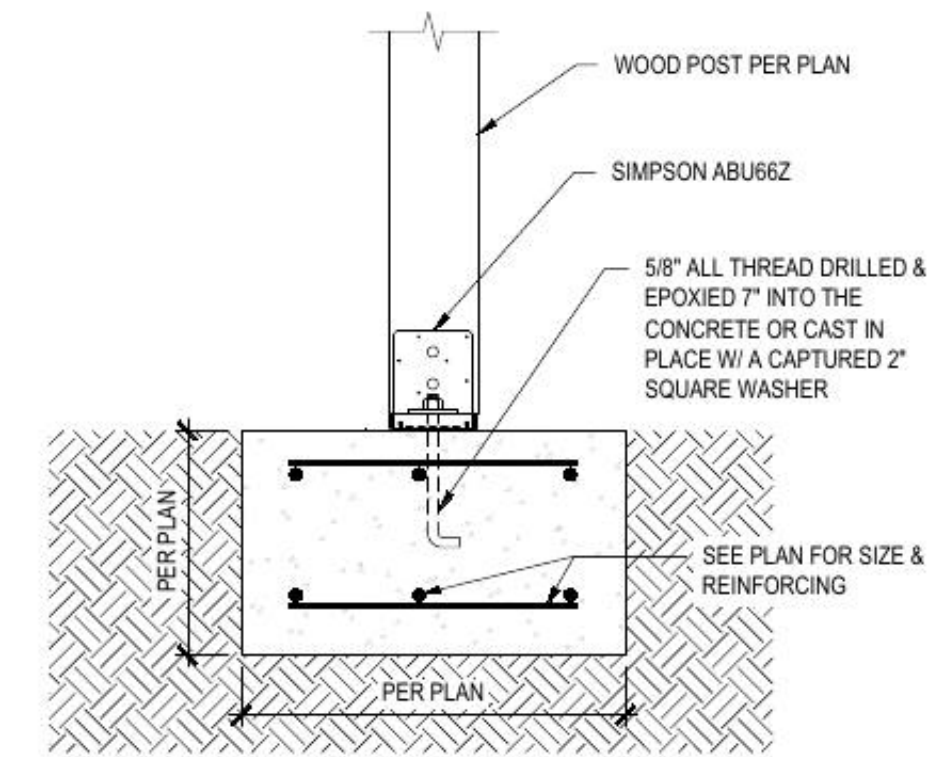



3 WOOD POST FOUNDATION DETAIL
SCALE: 1"=1'-0"

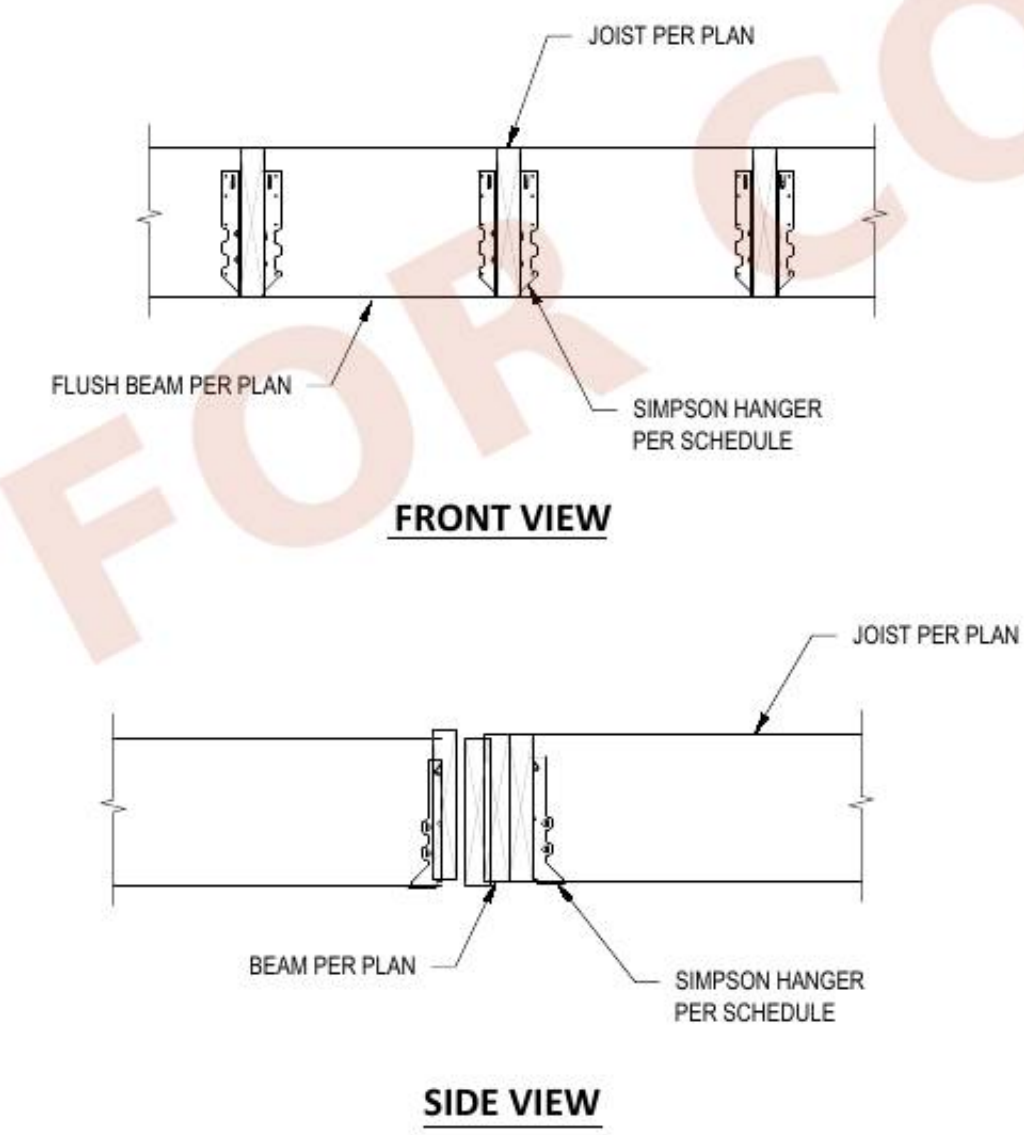


4 TYPICAL JOIST TO BEAM CONNECTION DETAIL
SCALE: 1"=1'-0"

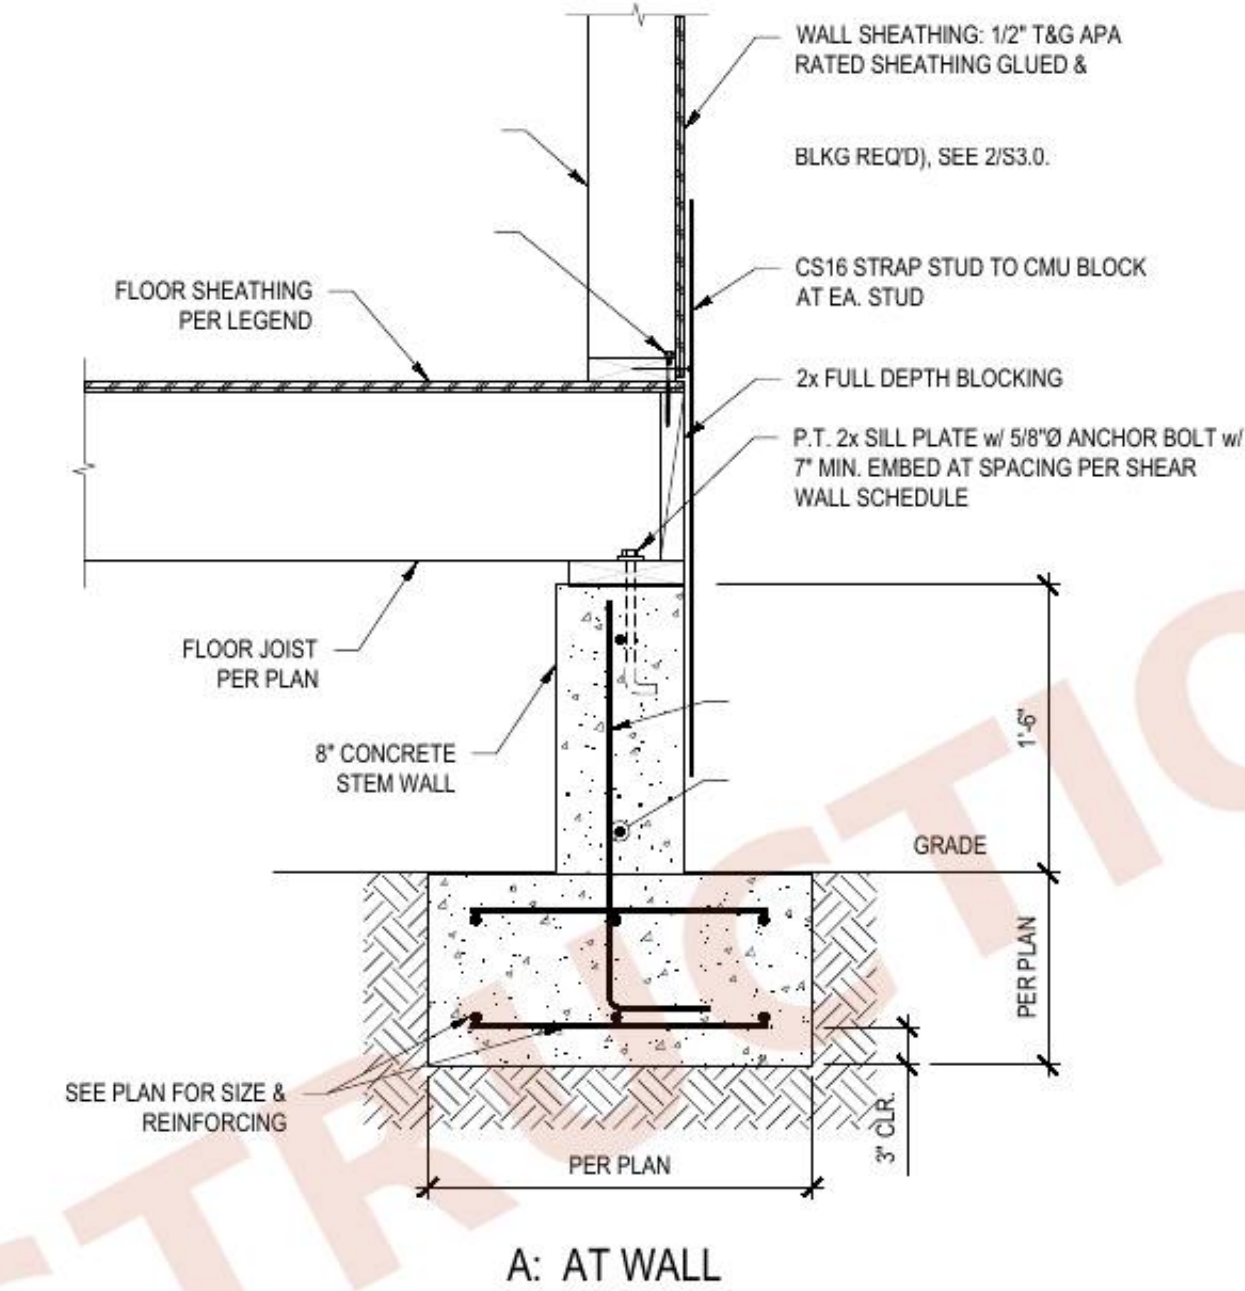


1 TYPICAL WALL FOOTING AT HOUSE
SCALE: 1"=1'-0"

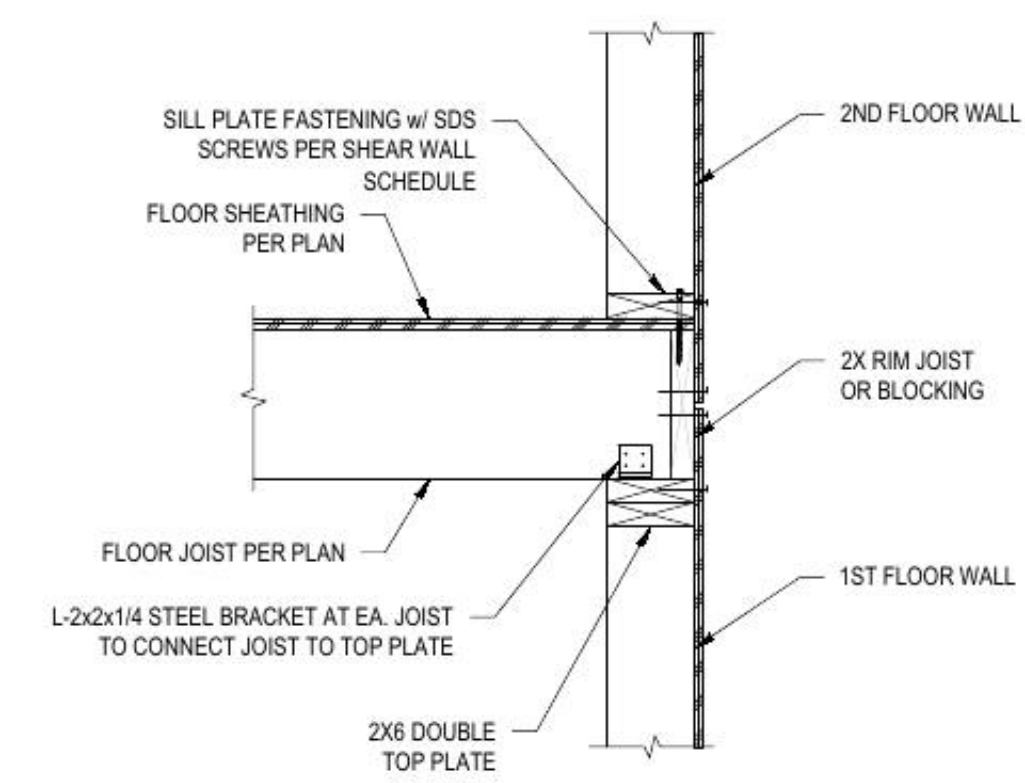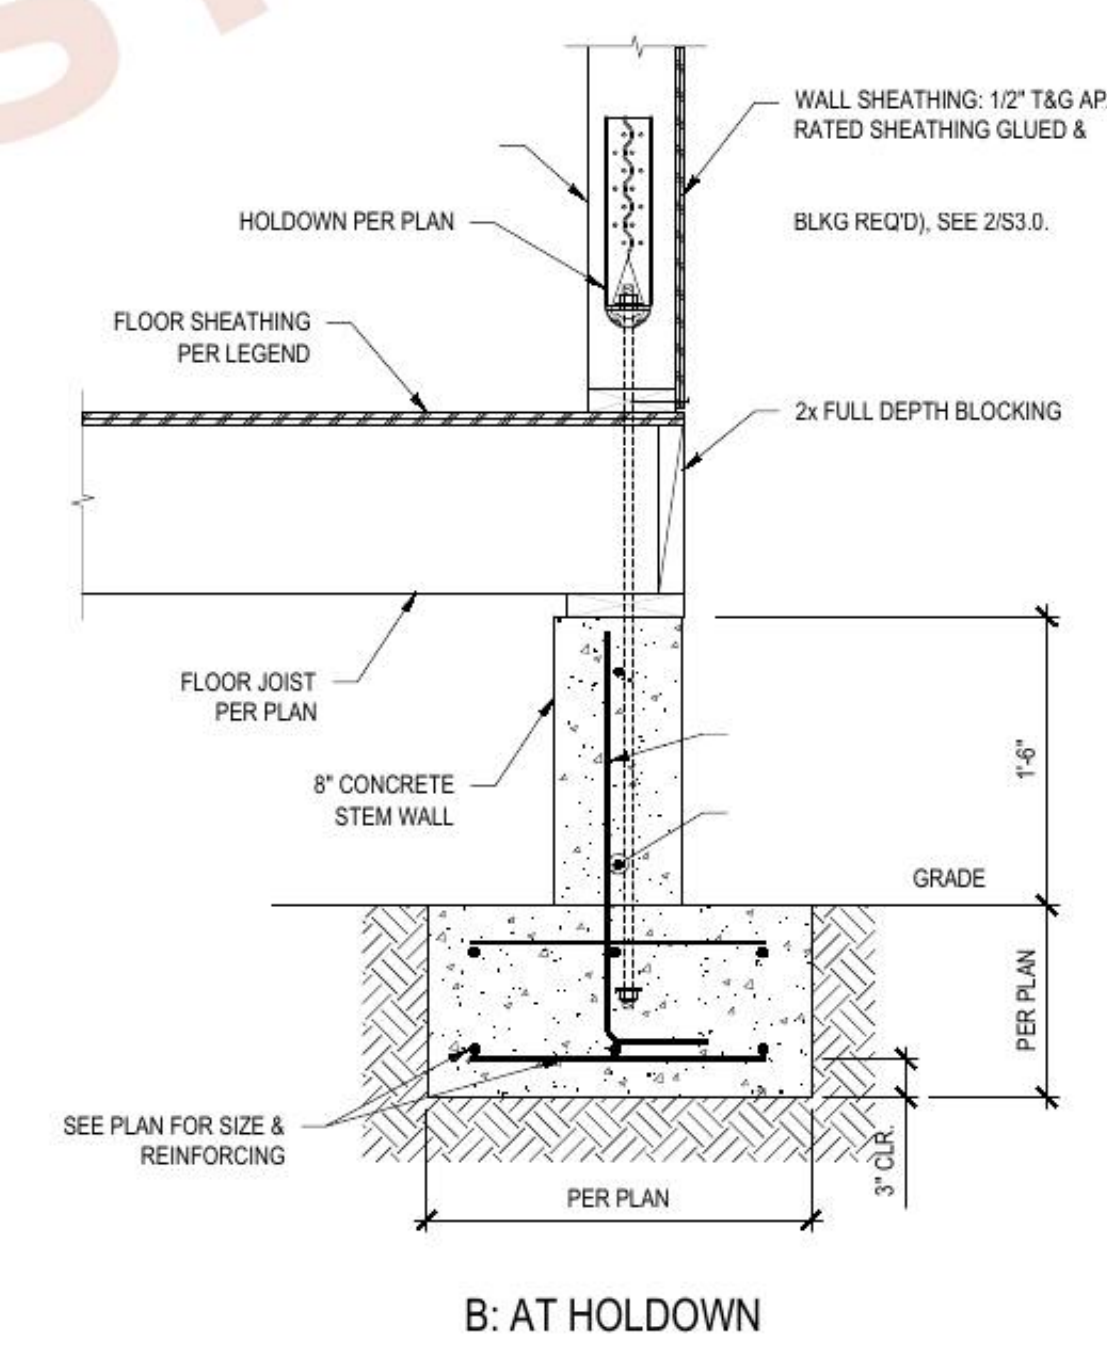

8 FLOOR JOIST TO WALL CONNECTION
SCALE: 1"=1'-0"

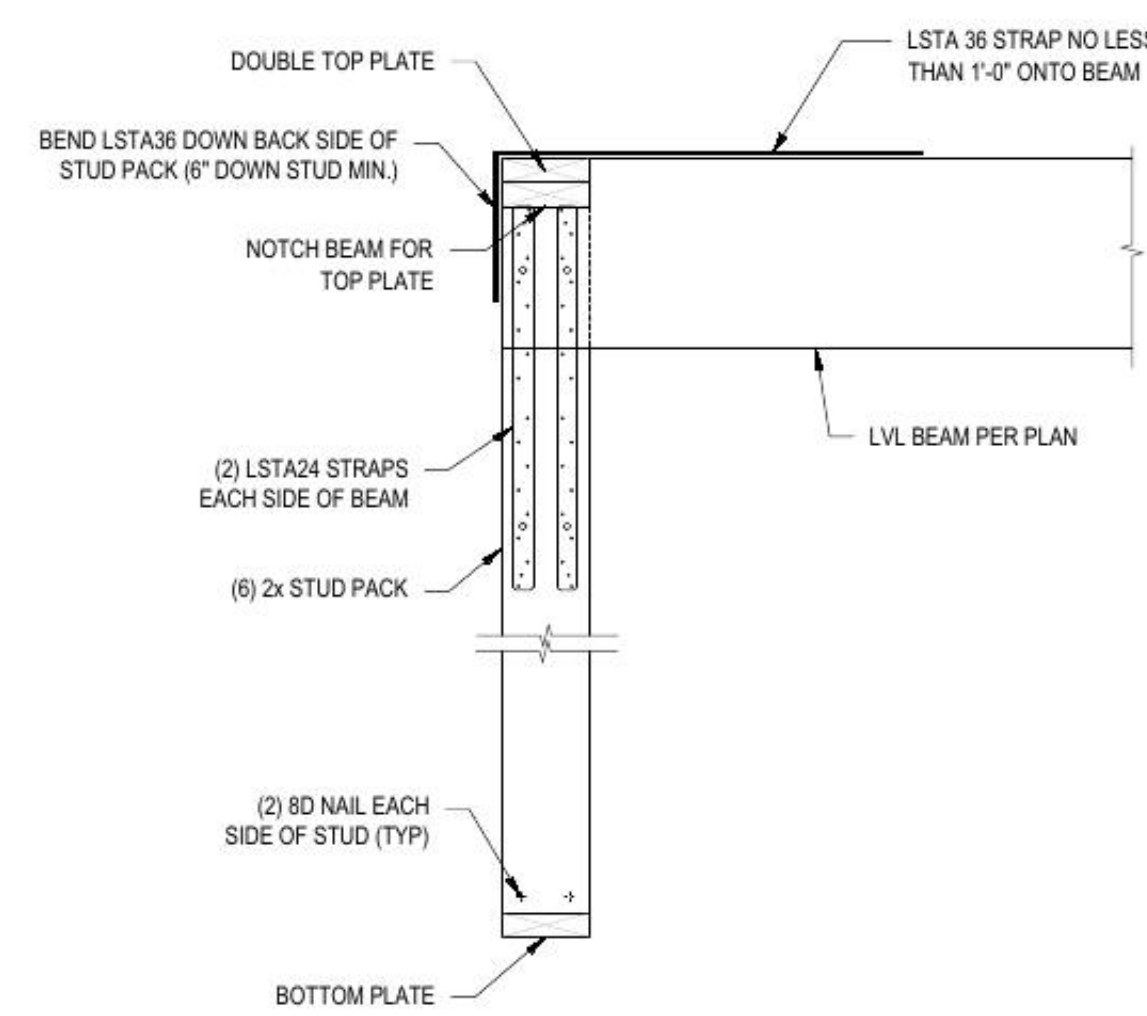

5 BEAM POCKET DETAIL
SCALE: 1"=1'-0"

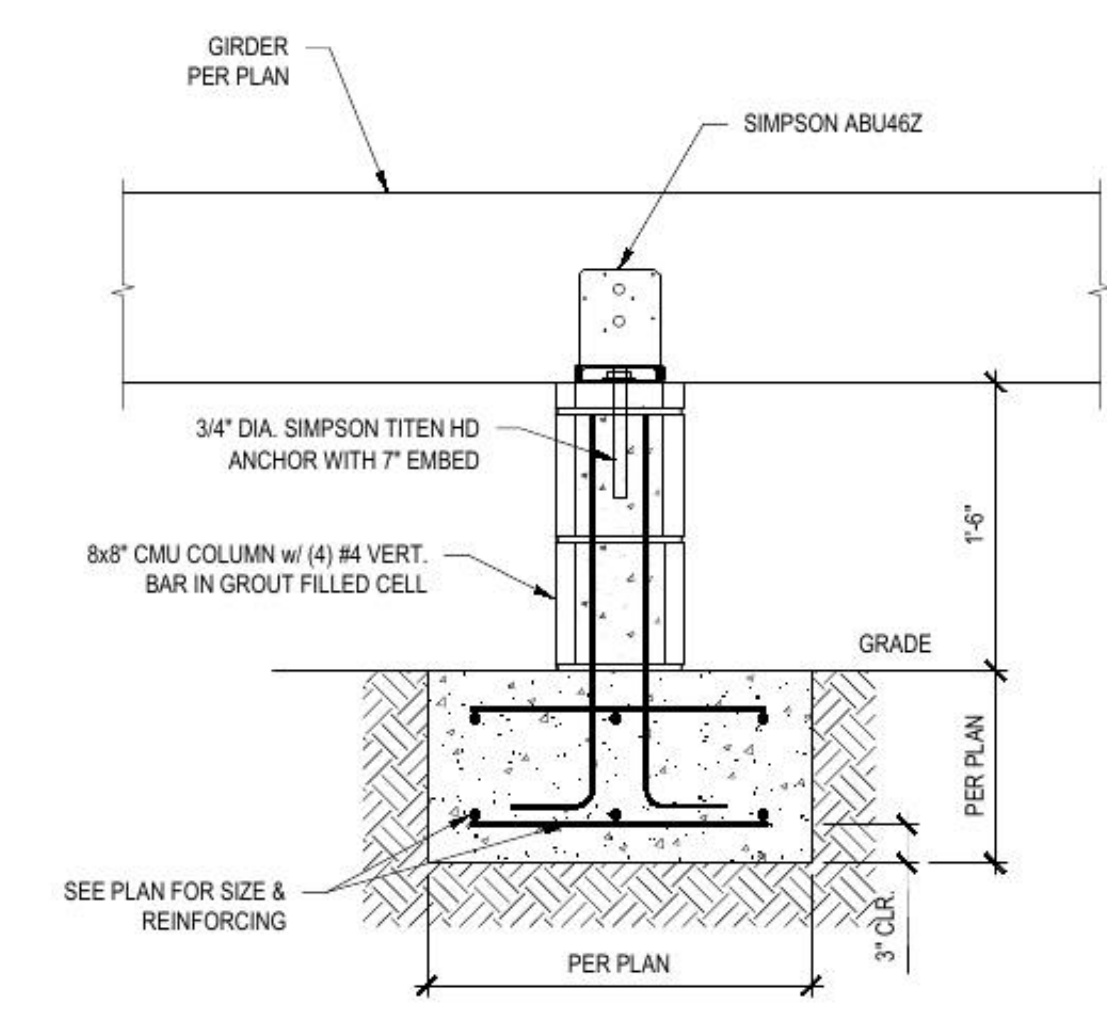

2 CMU COLUMN AT FOOTING DETAIL
SCALE: 1"=1'-0"

PROJECT #: 3078		
DRAWN BY: HL		
CHECKED BY: EL		
Revision Schedule		
Number	Description	Date

SHEET NAME

DETAILS (2)

SHEET NUMBER

S2.1

Need a set like this for your project?

This free sample shows a few sheets from a real As-Built permit set.

Client names, addresses and the full structural set have been removed.

A complete custom set from House Architecture USA includes:

- Every sheet your building department asks for, drawn to your site
- Structural design, framing/footing sizes and load calculations
- Engineer stamp available in all 50 states
- Revisions until the plans are approved

Get a free quote →